

TULMAR

**Work Order ID 111756**

**\*111756\***

Page 1

Tuesday, January 21, 2014 10:47:08 AM

Item ID: PB67-43001-85 Accept **\*N900040100\*** Setup Start **\*NS1\***  
 Revision ID: Stop **\*NS2\***  
 Item Name: D-Pad Assembly, Long  
 Start Date: 1/21/2014 Start Qty: 20.00 **\*20\*** Cust Item ID:  
 Required Date: 2/7/2014 Req'd Qty: 20.00 **\*20\*** Customer:  
 Reference:

Approvals: Process Plan: mf Date: 14-1-21 Tooling: \_\_\_\_\_ Date: \_\_\_\_\_ Run Start **\*NR1\***  
 QC: \_\_\_\_\_ Date: \_\_\_\_\_ SPC (Y/N): \_\_\_\_\_ Date: \_\_\_\_\_ Stop **\*NR2\***

| Sequence ID/<br>Work Center ID | Operation<br>Description                           | Set Up/<br>Run Hours | Tool ID | Tool # | Plan<br>Code | Accept<br>Qty | Reject<br>Qty | Reject<br>Number | Insp.<br>Stamp |
|--------------------------------|----------------------------------------------------|----------------------|---------|--------|--------------|---------------|---------------|------------------|----------------|
| <b>Draw Nbr</b>                | <b>Revision Nbr</b>                                |                      |         |        |              |               |               |                  |                |
| B67-43001-85                   | Rev C                                              |                      |         |        |              |               |               |                  |                |
| 100                            | Pick Kit                                           | 0.00                 |         |        |              |               |               |                  |                |
| <b>*100*</b>                   |                                                    |                      |         |        |              |               |               |                  |                |
| Packaging                      | Memo                                               | 0.00                 |         |        |              |               |               |                  |                |
| Packaging                      |                                                    |                      |         |        |              |               |               |                  |                |
| 110                            | Large Fab                                          | 0.00                 |         |        |              |               |               |                  |                |
| <b>*110*</b>                   |                                                    |                      |         |        |              |               |               |                  |                |
| Large Fab                      | Memo                                               | 0.00                 |         |        |              |               |               |                  |                |
| Large Fab                      | 1- assemble and weld as per dwg B67-43001 (QSI004) |                      |         |        |              |               |               |                  |                |
| 120                            | Small Fab                                          | 0.00                 |         |        |              |               |               |                  |                |
| <b>*120*</b>                   |                                                    |                      |         |        |              |               |               |                  |                |
| Small Fab                      | Memo                                               | 0.00                 |         |        |              |               |               |                  |                |
| Small Fab                      | 1- grind weld flush only on side of -193           |                      |         |        |              |               |               |                  |                |

(20) 14-01-29 80

(20) 14-01-29 80

(20) 14-01-29 80

DQA:

Date:

14/04/04



## WORK ORDER NON-CONFORMANCE / UPDATE

QA Closed:

Date:

14-4-14

Work Order update only ☐

|                               |   |                                        |                                    |                                              |                                      |
|-------------------------------|---|----------------------------------------|------------------------------------|----------------------------------------------|--------------------------------------|
| Work Order: <u>111756</u>     | <b>DISPOSITION</b><br>Rework <input type="checkbox"/><br>Scrap <input type="checkbox"/><br>Use-as-is <input checked="" type="checkbox"/><br>Suspected Unapproved <input type="checkbox"/> | <b>AGAINST DEPARTMENT/PROCESS</b>      |                                    |                                              |                                      |
| Part No. <u>PB67-43001-85</u> |   | Skid-tube <input type="checkbox"/>     | Crosstube <input type="checkbox"/> | Water Jet <input type="checkbox"/>           | Engineering <input type="checkbox"/> |
| NCR No. <u>14-3706</u>        |   | Machining <input type="checkbox"/>     | Small Fab <input type="checkbox"/> | Prod. Eng. Coord. <input type="checkbox"/>   | Quality <input type="checkbox"/>     |
|                               |   | Thermoforming <input type="checkbox"/> | Finishing <input type="checkbox"/> | Rec/Store/Packaging <input type="checkbox"/> | Other <input type="checkbox"/>       |
|                               |   | Large Fab <input type="checkbox"/>     | Composite <input type="checkbox"/> | Supplier <input type="checkbox"/>            |                                      |

| Root Cause    | Date   | Step | Qty | Description of work order update or non-conformance                                          | Initial Chief Eng               | Action Description                                 | Sign & Date                     | Verification              | QC Inspector                     |
|---------------|--------|------|-----|----------------------------------------------------------------------------------------------|---------------------------------|----------------------------------------------------|---------------------------------|---------------------------|----------------------------------|
| Design        | 14/3/4 | 100  | 20  | FOAM: SBR/EPDM/LR<br>BLEND BLACK, ASTM<br>D1056 ZAL, 1/8" THICK<br><br>ADHESIVE: LA4009N6/6C | DAS<br>12<br>9-89<br><br>14/3/4 | Acceptable deviation.<br><br>PART IS NOT AIRWORTHY | DAS<br>12<br>9-89<br><br>14/3/4 | 27<br>9-89<br><br>14/3/27 | DAS<br>27<br>9-89<br><br>14/3/27 |
| Doc/Data      |        |      |     |                                                                                              |                                 |                                                    |                                 |                           |                                  |
| Equip/Tooling |        |      |     |                                                                                              |                                 |                                                    |                                 |                           |                                  |
| Handling/Pre  |        |      |     |                                                                                              |                                 |                                                    |                                 |                           |                                  |
| Material      |        |      |     |                                                                                              |                                 |                                                    |                                 |                           |                                  |
| Operator      |        |      |     |                                                                                              |                                 |                                                    |                                 |                           |                                  |
| Offset/Setup  |        |      |     |                                                                                              |                                 |                                                    |                                 |                           |                                  |
| Process       |        |      |     |                                                                                              |                                 |                                                    |                                 |                           |                                  |
| Supplier      |        |      |     |                                                                                              |                                 |                                                    |                                 |                           |                                  |
| Training      |        |      |     |                                                                                              |                                 |                                                    |                                 |                           |                                  |
| Transport     |        |      |     |                                                                                              |                                 |                                                    |                                 |                           |                                  |
| Unapproved    |        |      |     |                                                                                              |                                 |                                                    |                                 |                           |                                  |

## FAULT CATEGORY

|   |   |   |   |   |
|---|---|---|---|---|
| <b>Landing Gear</b><br><input type="checkbox"/> Bending<br><input type="checkbox"/> Centre Not Concentric<br><input type="checkbox"/> Cracks<br><input type="checkbox"/> Crimp/Kink/Ripple/Wave<br><input type="checkbox"/> Cuffs<br><input type="checkbox"/> Crushing<br><input type="checkbox"/> Heat Treat<br><input type="checkbox"/> Inspection Strip in Tube<br><input type="checkbox"/> Marks/Chatter<br><input type="checkbox"/> Turning Sequence<br><input type="checkbox"/> Wave/Twist in Tube | <b>General</b><br><input type="checkbox"/> Bend<br><input type="checkbox"/> BOM/Route<br><input type="checkbox"/> Broken/Damage/Defect<br><input type="checkbox"/> Burrs<br><input type="checkbox"/> Contamination<br><input type="checkbox"/> Countersink<br><input type="checkbox"/> Cut Too Short<br><input type="checkbox"/> Drawing<br><input type="checkbox"/> Drill Holes<br><input type="checkbox"/> Finish<br><input type="checkbox"/> Fit/Function | <input type="checkbox"/> Folio/Program<br><input type="checkbox"/> Grain<br><input type="checkbox"/> Hardware<br><input type="checkbox"/> Inspection Incomplete/Unqualified<br><input type="checkbox"/> Instructions Incomplete/Unclear<br><input type="checkbox"/> Misaligned/off center<br><input type="checkbox"/> Mislabeled<br><input type="checkbox"/> Misread<br><input type="checkbox"/> Off-set<br><input type="checkbox"/> Out of Calibration<br><input type="checkbox"/> Out of Sequence | <input type="checkbox"/> Outside Dimensions<br><input type="checkbox"/> Over/Under tolerance<br><input type="checkbox"/> Part Incorrect<br><input type="checkbox"/> Part Lost/Missing<br><input type="checkbox"/> Part Moved<br><input type="checkbox"/> Positioned Wrong<br><input type="checkbox"/> Power Loss/Surge | <input type="checkbox"/> Pressure/Forced<br><input type="checkbox"/> Set-up<br><input type="checkbox"/> Temperature/Cure<br><input type="checkbox"/> Weld<br><input type="checkbox"/> Wrong Stock Pulled<br><input type="checkbox"/> Other |
|---|---|---|---|---|

# Work Order ID 111756

Tuesday, January 21, 2014 10:47:08 AM

**\*111756\***

Page 2

Item ID: PB67-43001-85 Accept **\*N900040100\*** Setup Start **\*NS1\***  
Revision ID: Stop **\*NS2\***  
Item Name: D-Pad Assembly, Long  
Start Date: 1/21/2014 Start Qty: 20.00 **\*20\*** Cust Item ID:  
Required Date: 2/7/2014 Req'd Qty: 20.00 **\*20\*** Customer:  
Reference:

Approvals: Process Plan: \_\_\_\_\_ Date: \_\_\_\_\_ Tooling: \_\_\_\_\_ Date: \_\_\_\_\_ Run Start **\*NR1\***  
QC: \_\_\_\_\_ Date: \_\_\_\_\_ SPC (Y/N): \_\_\_\_\_ Date: \_\_\_\_\_ Stop **\*NR2\***

| Sequence ID/<br>Work Center ID                      | Operation<br>Description                                                                                   | Set Up/<br>Run Hours | Tool ID     | Tool # | Plan<br>Code | Accept<br>Qty | Reject<br>Qty | Reject<br>Number | Insp.<br>Stamp |
|-----------------------------------------------------|---|----------------------|-------------|--------|--------------|---------------|---------------|------------------|----------------|
| 130<br><b>*130*</b><br>QC<br>Quality Control        | QC9- Inspect visual per QSI004- Fusion Welds<br><br>Memo                                                   | 0.00<br><br>0.00     | PC 14.01.29 |        |              | 20            |               |                  |                |
| 140<br><b>*140*</b><br>QC<br>Quality Control        | QC5- Inspect part completeness to step on W/O<br><br>Memo                                                  | 0.00<br><br>0.00     | PC 14.01.29 |        |              | 20            |               |                  |                |
| 150<br><b>*150*</b><br>Powdercoat<br>Powder Coating | Green Sandtex(Ref:4.3.5.8) per QSI005 4.3<br><br>M111277.<br>Memo<br>START TIME: 2:45<br>FINISH TIME: 3:15 | 0.00<br><br>0.00     |             |        |              | 20            | Ø             | 14-1-30.         | DAS 34 9.89    |

DQA: \_\_\_\_\_ Date: \_\_\_\_\_



## WORK ORDER NON-CONFORMANCE / UPDATE

QA Closed: \_\_\_\_\_ Date: \_\_\_\_\_

Work Order update only ☐

|                                                              |   |   |                                      |                                    |                                    |                                      |                                    |                                    |                                            |                                  |                                        |                                    |                                              |                                |                                    |                                    |                                   |  |
|--------------------------------------------------------------|---|---|--------------------------------------|------------------------------------|------------------------------------|--------------------------------------|------------------------------------|------------------------------------|--------------------------------------------|----------------------------------|----------------------------------------|------------------------------------|----------------------------------------------|--------------------------------|------------------------------------|------------------------------------|-----------------------------------|--|
| Work Order: _____<br><br>Part No. _____<br><br>NCR No. _____ | <b>DISPOSITION</b><br><br>Rework <input type="checkbox"/><br>Scrap <input type="checkbox"/><br>Use-as-is <input type="checkbox"/><br>Suspected Unapproved <input type="checkbox"/> | <b>AGAINST DEPARTMENT/PROCESS</b><br><br><table style="width:100%;"> <tr> <td>Skid-tube <input type="checkbox"/></td> <td>Crosstube <input type="checkbox"/></td> <td>Water Jet <input type="checkbox"/></td> <td>Engineering <input type="checkbox"/></td> </tr> <tr> <td>Machining <input type="checkbox"/></td> <td>Small Fab <input type="checkbox"/></td> <td>Prod. Eng. Coord. <input type="checkbox"/></td> <td>Quality <input type="checkbox"/></td> </tr> <tr> <td>Thermoforming <input type="checkbox"/></td> <td>Finishing <input type="checkbox"/></td> <td>Rec/Store/Packaging <input type="checkbox"/></td> <td>Other <input type="checkbox"/></td> </tr> <tr> <td>Large Fab <input type="checkbox"/></td> <td>Composite <input type="checkbox"/></td> <td>Supplier <input type="checkbox"/></td> <td></td> </tr> </table> | Skid-tube <input type="checkbox"/>   | Crosstube <input type="checkbox"/> | Water Jet <input type="checkbox"/> | Engineering <input type="checkbox"/> | Machining <input type="checkbox"/> | Small Fab <input type="checkbox"/> | Prod. Eng. Coord. <input type="checkbox"/> | Quality <input type="checkbox"/> | Thermoforming <input type="checkbox"/> | Finishing <input type="checkbox"/> | Rec/Store/Packaging <input type="checkbox"/> | Other <input type="checkbox"/> | Large Fab <input type="checkbox"/> | Composite <input type="checkbox"/> | Supplier <input type="checkbox"/> |  |
| Skid-tube <input type="checkbox"/>                           | Crosstube <input type="checkbox"/>   | Water Jet <input type="checkbox"/>   | Engineering <input type="checkbox"/> |                                    |                                    |                                      |                                    |                                    |                                            |                                  |                                        |                                    |                                              |                                |                                    |                                    |                                   |  |
| Machining <input type="checkbox"/>                           | Small Fab <input type="checkbox"/>   | Prod. Eng. Coord. <input type="checkbox"/>   | Quality <input type="checkbox"/>     |                                    |                                    |                                      |                                    |                                    |                                            |                                  |                                        |                                    |                                              |                                |                                    |                                    |                                   |  |
| Thermoforming <input type="checkbox"/>                       | Finishing <input type="checkbox"/>   | Rec/Store/Packaging <input type="checkbox"/>   | Other <input type="checkbox"/>       |                                    |                                    |                                      |                                    |                                    |                                            |                                  |                                        |                                    |                                              |                                |                                    |                                    |                                   |  |
| Large Fab <input type="checkbox"/>                           | Composite <input type="checkbox"/>   | Supplier <input type="checkbox"/>   |                                      |                                    |                                    |                                      |                                    |                                    |                                            |                                  |                                        |                                    |                                              |                                |                                    |                                    |                                   |  |

| Root Cause    | Date | Step | Qty | Description of work order update or non-conformance | Initial Chief Eng | Action Description | Sign & Date | Verification | QC Inspector |
|---------------|------|------|-----|-----------------------------------------------------|-------------------|--------------------|-------------|--------------|--------------|
| Design        |      |      |     |                                                     |                   |                    |             |              |              |
| Doc/Data      |      |      |     |                                                     |                   |                    |             |              |              |
| Equip/Tooling |      |      |     |                                                     |                   |                    |             |              |              |
| Handling/Pre  |      |      |     |                                                     |                   |                    |             |              |              |
| Material      |      |      |     |                                                     |                   |                    |             |              |              |
| Operator      |      |      |     |                                                     |                   |                    |             |              |              |
| Offset/Setup  |      |      |     |                                                     |                   |                    |             |              |              |
| Process       |      |      |     |                                                     |                   |                    |             |              |              |
| Supplier      |      |      |     |                                                     |                   |                    |             |              |              |
| Training      |      |      |     |                                                     |                   |                    |             |              |              |
| Transport     |      |      |     |                                                     |                   |                    |             |              |              |
| Unapproved    |      |      |     |                                                     |                   |                    |             |              |              |

### FAULT CATEGORY

|   |   |   |
|---|---|---|
| <b>Landing Gear</b><br><input type="checkbox"/> Bending<br><input type="checkbox"/> Centre Not Concentric<br><input type="checkbox"/> Cracks<br><input type="checkbox"/> Crimp/Kink/Ripple/Wave<br><input type="checkbox"/> Cuffs<br><input type="checkbox"/> Crushing<br><input type="checkbox"/> Heat Treat<br><input type="checkbox"/> Inspection Strip in Tube<br><input type="checkbox"/> Marks/Chatter<br><input type="checkbox"/> Turning Sequence<br><input type="checkbox"/> Wave/Twist in Tube | <b>General</b><br><input type="checkbox"/> Bend<br><input type="checkbox"/> BOM/Route<br><input type="checkbox"/> Broken/Damage/Defect<br><input type="checkbox"/> Burrs<br><input type="checkbox"/> Contamination<br><input type="checkbox"/> Countersink<br><input type="checkbox"/> Cut Too Short<br><input type="checkbox"/> Drawing<br><input type="checkbox"/> Drill Holes<br><input type="checkbox"/> Finish<br><input type="checkbox"/> Fit/Function | <input type="checkbox"/> Folio/Program<br><input type="checkbox"/> Grain<br><input type="checkbox"/> Hardware<br><input type="checkbox"/> Inspection Incomplete/Unqualified<br><input type="checkbox"/> Instructions Incomplete/Unclear<br><input type="checkbox"/> Misaligned/off center<br><input type="checkbox"/> Mislabeled<br><input type="checkbox"/> Misread<br><input type="checkbox"/> Off-set<br><input type="checkbox"/> Out of Calibration<br><input type="checkbox"/> Out of Sequence |
| <input type="checkbox"/> Outside Dimensions<br><input type="checkbox"/> Over/Under tolerance<br><input type="checkbox"/> Part Incorrect<br><input type="checkbox"/> Part Lost/Missing<br><input type="checkbox"/> Part Moved<br><input type="checkbox"/> Positioned Wrong<br><input type="checkbox"/> Power Loss/Surge   |   |   |
| <input type="checkbox"/> Pressure/Forced<br><input type="checkbox"/> Set-up<br><input type="checkbox"/> Temperature/Cure<br><input type="checkbox"/> Weld<br><input type="checkbox"/> Wrong Stock Pulled<br><input type="checkbox"/> Other   |   |   |

**\*111756\***

*Tuesday, January 21, 2014 10:47:08 AM*

**\*N900040100\***

Setup Start \*NS1\*

Stop \*NS2\*

\*20\*

**\*20\***

**Reference:**

Run Start \*NR1\*

Stop \*NR2\*

| Accept Qty | Reject Qty | Reject Number | Insp. Stamp |
|------------|------------|---------------|-------------|
|            |            |               |             |

0.00

0.00

## Memo

0.00

## PURCHASING

## Memo

SEND TO TALMAR FOR FOAM AND FABRIC

0.00

Receive & Inspect for Damage & Mat'l Certs

0.00

0.00

### Packaging

## Packaging

DQA: \_\_\_\_\_ Date: \_\_\_\_\_



## WORK ORDER NON-CONFORMANCE / UPDATE

QA Closed: \_\_\_\_\_ Date: \_\_\_\_\_

Work Order update only ☐

|                                                              |   |   |                                      |                                    |                                    |                                      |                                    |                                    |                                            |                                  |                                        |                                    |                                              |                                |                                    |                                    |                                   |  |
|--------------------------------------------------------------|---|---|--------------------------------------|------------------------------------|------------------------------------|--------------------------------------|------------------------------------|------------------------------------|--------------------------------------------|----------------------------------|----------------------------------------|------------------------------------|----------------------------------------------|--------------------------------|------------------------------------|------------------------------------|-----------------------------------|--|
| Work Order: _____<br><br>Part No. _____<br><br>NCR No. _____ | <b>DISPOSITION</b><br><br>Rework <input type="checkbox"/><br>Scrap <input type="checkbox"/><br>Use-as-is <input type="checkbox"/><br>Suspected Unapproved <input type="checkbox"/> | <b>AGAINST DEPARTMENT/PROCESS</b><br><br><table style="width:100%;"> <tr> <td>Skid-tube <input type="checkbox"/></td> <td>Crosstube <input type="checkbox"/></td> <td>Water Jet <input type="checkbox"/></td> <td>Engineering <input type="checkbox"/></td> </tr> <tr> <td>Machining <input type="checkbox"/></td> <td>Small Fab <input type="checkbox"/></td> <td>Prod. Eng. Coord. <input type="checkbox"/></td> <td>Quality <input type="checkbox"/></td> </tr> <tr> <td>Thermoforming <input type="checkbox"/></td> <td>Finishing <input type="checkbox"/></td> <td>Rec/Store/Packaging <input type="checkbox"/></td> <td>Other <input type="checkbox"/></td> </tr> <tr> <td>Large Fab <input type="checkbox"/></td> <td>Composite <input type="checkbox"/></td> <td>Supplier <input type="checkbox"/></td> <td></td> </tr> </table> | Skid-tube <input type="checkbox"/>   | Crosstube <input type="checkbox"/> | Water Jet <input type="checkbox"/> | Engineering <input type="checkbox"/> | Machining <input type="checkbox"/> | Small Fab <input type="checkbox"/> | Prod. Eng. Coord. <input type="checkbox"/> | Quality <input type="checkbox"/> | Thermoforming <input type="checkbox"/> | Finishing <input type="checkbox"/> | Rec/Store/Packaging <input type="checkbox"/> | Other <input type="checkbox"/> | Large Fab <input type="checkbox"/> | Composite <input type="checkbox"/> | Supplier <input type="checkbox"/> |  |
| Skid-tube <input type="checkbox"/>                           | Crosstube <input type="checkbox"/>   | Water Jet <input type="checkbox"/>   | Engineering <input type="checkbox"/> |                                    |                                    |                                      |                                    |                                    |                                            |                                  |                                        |                                    |                                              |                                |                                    |                                    |                                   |  |
| Machining <input type="checkbox"/>                           | Small Fab <input type="checkbox"/>   | Prod. Eng. Coord. <input type="checkbox"/>   | Quality <input type="checkbox"/>     |                                    |                                    |                                      |                                    |                                    |                                            |                                  |                                        |                                    |                                              |                                |                                    |                                    |                                   |  |
| Thermoforming <input type="checkbox"/>                       | Finishing <input type="checkbox"/>   | Rec/Store/Packaging <input type="checkbox"/>   | Other <input type="checkbox"/>       |                                    |                                    |                                      |                                    |                                    |                                            |                                  |                                        |                                    |                                              |                                |                                    |                                    |                                   |  |
| Large Fab <input type="checkbox"/>                           | Composite <input type="checkbox"/>   | Supplier <input type="checkbox"/>   |                                      |                                    |                                    |                                      |                                    |                                    |                                            |                                  |                                        |                                    |                                              |                                |                                    |                                    |                                   |  |

| Root Cause    | Date | Step | Qty | Description of work order update or non-conformance | Initial Chief Eng | Action Description | Sign & Date | Verification | QC Inspector |
|---------------|------|------|-----|-----------------------------------------------------|-------------------|--------------------|-------------|--------------|--------------|
| Design        |      |      |     |                                                     |                   |                    |             |              |              |
| Doc/Data      |      |      |     |                                                     |                   |                    |             |              |              |
| Equip/Tooling |      |      |     |                                                     |                   |                    |             |              |              |
| Handling/Pre  |      |      |     |                                                     |                   |                    |             |              |              |
| Material      |      |      |     |                                                     |                   |                    |             |              |              |
| Operator      |      |      |     |                                                     |                   |                    |             |              |              |
| Offset/Setup  |      |      |     |                                                     |                   |                    |             |              |              |
| Process       |      |      |     |                                                     |                   |                    |             |              |              |
| Supplier      |      |      |     |                                                     |                   |                    |             |              |              |
| Training      |      |      |     |                                                     |                   |                    |             |              |              |
| Transport     |      |      |     |                                                     |                   |                    |             |              |              |
| Unapproved    |      |      |     |                                                     |                   |                    |             |              |              |

### FAULT CATEGORY

|   |   |   |   |
|---|---|---|---|
| <b>Landing Gear</b><br><input type="checkbox"/> Bending<br><input type="checkbox"/> Centre Not Concentric<br><input type="checkbox"/> Cracks<br><input type="checkbox"/> Crimp/Kink/Ripple/Wave<br><input type="checkbox"/> Cuffs<br><input type="checkbox"/> Crushing<br><input type="checkbox"/> Heat Treat<br><input type="checkbox"/> Inspection Strip in Tube<br><input type="checkbox"/> Marks/Chatter<br><input type="checkbox"/> Turning Sequence<br><input type="checkbox"/> Wave/Twist in Tube | <b>General</b><br><input type="checkbox"/> Bend<br><input type="checkbox"/> BOM/Route<br><input type="checkbox"/> Broken/Damage/Defect<br><input type="checkbox"/> Burrs<br><input type="checkbox"/> Contamination<br><input type="checkbox"/> Countersink<br><input type="checkbox"/> Cut Too Short<br><input type="checkbox"/> Drawing<br><input type="checkbox"/> Drill Holes<br><input type="checkbox"/> Finish<br><input type="checkbox"/> Fit/Function | <input type="checkbox"/> Folio/Program<br><input type="checkbox"/> Grain<br><input type="checkbox"/> Hardware<br><input type="checkbox"/> Inspection Incomplete/Unqualified<br><input type="checkbox"/> Instructions Incomplete/Unclear<br><input type="checkbox"/> Misaligned/off center<br><input type="checkbox"/> Mislabeled<br><input type="checkbox"/> Misread<br><input type="checkbox"/> Off-set<br><input type="checkbox"/> Out of Calibration<br><input type="checkbox"/> Out of Sequence | <input type="checkbox"/> Outside Dimensions<br><input type="checkbox"/> Over/Under tolerance<br><input type="checkbox"/> Part Incorrect<br><input type="checkbox"/> Part Lost/Missing<br><input type="checkbox"/> Part Moved<br><input type="checkbox"/> Positioned Wrong<br><input type="checkbox"/> Power Loss/Surge<br><br><input type="checkbox"/> Pressure/Forced<br><input type="checkbox"/> Set-up<br><input type="checkbox"/> Temperature/Cure<br><input type="checkbox"/> Weld<br><input type="checkbox"/> Wrong Stock Pulled<br><input type="checkbox"/> Other |
|---|---|---|---|

**Work Order ID 111756**

Tuesday, January 21, 2014 10:47:08 AM

**\*111756\***

Page 4

Item ID: PB67-43001-85

Accept

**\*N900040100\***Setup Start **\*NS1\***

Revision ID:

Stop **\*NS2\***

Item Name: D-Pad Assembly, Long

Start Date: 1/21/2014 Start Qty: 20.00

**\*20\***

Cust Item ID:

Required Date: 2/7/2014 Req'd Qty: 20.00

**\*20\***

Customer:

Reference:

Approvals: Process Plan: \_\_\_\_\_ Date: \_\_\_\_\_ Tooling: \_\_\_\_\_ Date: \_\_\_\_\_

Run Start **\*NR1\***

QC: \_\_\_\_\_ Date: \_\_\_\_\_ SPC (Y/N): \_\_\_\_\_ Date: \_\_\_\_\_

Stop **\*NR2\***

| Sequence ID/<br>Work Center ID                | Operation<br>Description                                | Set Up/<br>Run Hours                 | Tool ID | Tool # | Plan<br>Code | Accept<br>Qty | Reject<br>Qty | Reject<br>Number | Insp.<br>Stamp    |
|-----------------------------------------------|---------------------------------------------------------|--------------------------------------|---------|--------|--------------|---------------|---------------|------------------|-------------------|
| 190<br><b>*190*</b><br>QC<br>Quality Control  | QC6- Inspect dimensions to drawing<br><br>Memo          | 0.00<br>DAS<br>27<br>9-89<br>14/3/27 |         |        |              | 20            |               |                  |                   |
| 200<br><b>*200*</b><br>Packaging<br>Packaging | Identify as per dwg & Stock Location: _____<br><br>Memo | 0.00<br>0.00                         |         |        |              |               |               | 14/3/27 (20)     | DAS<br>32<br>9-89 |
| 210<br><b>*210*</b><br>QC<br>Quality Control  | QC21- Final Inspection - Work Order Release<br><br>Memo | 0.00<br>0.00                         |         |        |              |               |               | MCO 1403-28      |                   |

POSITIVE RECALL

EFFECTIVE 14/3/4 AUTH UP  
RELEASED UP DATE 14/3/28

CHECK FORM DENSITY

MF  
14-3-28

DQA: \_\_\_\_\_ Date: \_\_\_\_\_



## WORK ORDER NON-CONFORMANCE / UPDATE

QA Closed: \_\_\_\_\_ Date: \_\_\_\_\_

Work Order update only ☐

|                                                              |   |   |                                      |                                    |                                    |                                      |                                    |                                    |                                            |                                  |                                        |                                    |                                              |                                |                                    |                                    |                                   |  |
|--------------------------------------------------------------|---|---|--------------------------------------|------------------------------------|------------------------------------|--------------------------------------|------------------------------------|------------------------------------|--------------------------------------------|----------------------------------|----------------------------------------|------------------------------------|----------------------------------------------|--------------------------------|------------------------------------|------------------------------------|-----------------------------------|--|
| Work Order: _____<br><br>Part No. _____<br><br>NCR No. _____ | <b>DISPOSITION</b><br><br>Rework <input type="checkbox"/><br>Scrap <input type="checkbox"/><br>Use-as-is <input type="checkbox"/><br>Suspected Unapproved <input type="checkbox"/> | <b>AGAINST DEPARTMENT/PROCESS</b><br><br><table style="width:100%;"> <tr> <td>Skid-tube <input type="checkbox"/></td> <td>Crosstube <input type="checkbox"/></td> <td>Water Jet <input type="checkbox"/></td> <td>Engineering <input type="checkbox"/></td> </tr> <tr> <td>Machining <input type="checkbox"/></td> <td>Small Fab <input type="checkbox"/></td> <td>Prod. Eng. Coord. <input type="checkbox"/></td> <td>Quality <input type="checkbox"/></td> </tr> <tr> <td>Thermoforming <input type="checkbox"/></td> <td>Finishing <input type="checkbox"/></td> <td>Rec/Store/Packaging <input type="checkbox"/></td> <td>Other <input type="checkbox"/></td> </tr> <tr> <td>Large Fab <input type="checkbox"/></td> <td>Composite <input type="checkbox"/></td> <td>Supplier <input type="checkbox"/></td> <td></td> </tr> </table> | Skid-tube <input type="checkbox"/>   | Crosstube <input type="checkbox"/> | Water Jet <input type="checkbox"/> | Engineering <input type="checkbox"/> | Machining <input type="checkbox"/> | Small Fab <input type="checkbox"/> | Prod. Eng. Coord. <input type="checkbox"/> | Quality <input type="checkbox"/> | Thermoforming <input type="checkbox"/> | Finishing <input type="checkbox"/> | Rec/Store/Packaging <input type="checkbox"/> | Other <input type="checkbox"/> | Large Fab <input type="checkbox"/> | Composite <input type="checkbox"/> | Supplier <input type="checkbox"/> |  |
| Skid-tube <input type="checkbox"/>                           | Crosstube <input type="checkbox"/>   | Water Jet <input type="checkbox"/>   | Engineering <input type="checkbox"/> |                                    |                                    |                                      |                                    |                                    |                                            |                                  |                                        |                                    |                                              |                                |                                    |                                    |                                   |  |
| Machining <input type="checkbox"/>                           | Small Fab <input type="checkbox"/>   | Prod. Eng. Coord. <input type="checkbox"/>   | Quality <input type="checkbox"/>     |                                    |                                    |                                      |                                    |                                    |                                            |                                  |                                        |                                    |                                              |                                |                                    |                                    |                                   |  |
| Thermoforming <input type="checkbox"/>                       | Finishing <input type="checkbox"/>   | Rec/Store/Packaging <input type="checkbox"/>   | Other <input type="checkbox"/>       |                                    |                                    |                                      |                                    |                                    |                                            |                                  |                                        |                                    |                                              |                                |                                    |                                    |                                   |  |
| Large Fab <input type="checkbox"/>                           | Composite <input type="checkbox"/>   | Supplier <input type="checkbox"/>   |                                      |                                    |                                    |                                      |                                    |                                    |                                            |                                  |                                        |                                    |                                              |                                |                                    |                                    |                                   |  |

| Root Cause    | Date | Step | Qty | Description of work order update or non-conformance | Initial Chief Eng | Action Description | Sign & Date | Verification | QC Inspector |
|---------------|------|------|-----|-----------------------------------------------------|-------------------|--------------------|-------------|--------------|--------------|
| Design        |      |      |     |                                                     |                   |                    |             |              |              |
| Doc/Data      |      |      |     |                                                     |                   |                    |             |              |              |
| Equip/Tooling |      |      |     |                                                     |                   |                    |             |              |              |
| Handling/Pre  |      |      |     |                                                     |                   |                    |             |              |              |
| Material      |      |      |     |                                                     |                   |                    |             |              |              |
| Operator      |      |      |     |                                                     |                   |                    |             |              |              |
| Offset/Setup  |      |      |     |                                                     |                   |                    |             |              |              |
| Process       |      |      |     |                                                     |                   |                    |             |              |              |
| Supplier      |      |      |     |                                                     |                   |                    |             |              |              |
| Training      |      |      |     |                                                     |                   |                    |             |              |              |
| Transport     |      |      |     |                                                     |                   |                    |             |              |              |
| Unapproved    |      |      |     |                                                     |                   |                    |             |              |              |

### FAULT CATEGORY

|   |   |   |   |
|---|---|---|---|
| <b>Landing Gear</b><br><input type="checkbox"/> Bending<br><input type="checkbox"/> Centre Not Concentric<br><input type="checkbox"/> Cracks<br><input type="checkbox"/> Crimp/Kink/Ripple/Wave<br><input type="checkbox"/> Cuffs<br><input type="checkbox"/> Crushing<br><input type="checkbox"/> Heat Treat<br><input type="checkbox"/> Inspection Strip in Tube<br><input type="checkbox"/> Marks/Chatter<br><input type="checkbox"/> Turning Sequence<br><input type="checkbox"/> Wave/Twist in Tube | <b>General</b><br><input type="checkbox"/> Bend<br><input type="checkbox"/> BOM/Route<br><input type="checkbox"/> Broken/Damage/Defect<br><input type="checkbox"/> Burrs<br><input type="checkbox"/> Contamination<br><input type="checkbox"/> Countersink<br><input type="checkbox"/> Cut Too Short<br><input type="checkbox"/> Drawing<br><input type="checkbox"/> Drill Holes<br><input type="checkbox"/> Finish<br><input type="checkbox"/> Fit/Function | <input type="checkbox"/> Folio/Program<br><input type="checkbox"/> Grain<br><input type="checkbox"/> Hardware<br><input type="checkbox"/> Inspection Incomplete/Unqualified<br><input type="checkbox"/> Instructions Incomplete/Unclear<br><input type="checkbox"/> Misaligned/off center<br><input type="checkbox"/> Mislabeled<br><input type="checkbox"/> Misread<br><input type="checkbox"/> Off-set<br><input type="checkbox"/> Out of Calibration<br><input type="checkbox"/> Out of Sequence | <input type="checkbox"/> Outside Dimensions<br><input type="checkbox"/> Over/Under tolerance<br><input type="checkbox"/> Part Incorrect<br><input type="checkbox"/> Part Lost/Missing<br><input type="checkbox"/> Part Moved<br><input type="checkbox"/> Positioned Wrong<br><input type="checkbox"/> Power Loss/Surge<br><br><input type="checkbox"/> Pressure/Forced<br><input type="checkbox"/> Set-up<br><input type="checkbox"/> Temperature/Cure<br><input type="checkbox"/> Weld<br><input type="checkbox"/> Wrong Stock Pulled<br><input type="checkbox"/> Other<br><br>_____<br>_____<br>_____ |
|---|---|---|---|



# Picklist Print

Tuesday, January 21, 2014 10:47:07 AM

Page 1

Work Order ID: 111756

Parent Item: PB67-43001-85

Parent Item Name: D-Pad Assembly, Long

Start Date: 1/21/2014

Required Date: 2/7/2014

Start Qty: 20.00

Required Qty: 20.00

Comments: IPP rev A new issue 08.06.19 EC verified: DD IPP rev B 10.09.30 per rev C  
dwg EC verified by:DD

| Component Item ID/<br>Item Name    | Replacement<br>Item ID | Mfg/<br>Purch | Bin<br>Item | Primary<br>Location | Last<br>Location | Route<br>Seq ID | Unit of<br>Measure | Qty on<br>Hand  | Qty per Kit | Total<br>Qty | Qty<br>Issued | Date<br>Issued              | Status |
|------------------------------------|------------------------|---------------|-------------|---------------------|------------------|-----------------|--------------------|-----------------|-------------|--------------|---------------|-----------------------------|--------|
| PB67-43001-191<br>D-Pad Back Plate |                        | Manufactured  | No          |                     |                  | 110             | Each               | 15.0000         | 1           | 20           |               | (20) 14-01-27 PD            |        |
|                                    |                        |               |             | <u>Location</u>     |                  | <u>Loc Qty</u>  |                    | <u>Loc Code</u> |             |              |               |                             |        |
|                                    |                        |               |             | Mezz2               |                  | 15              |                    |                 |             |              |               | B111703 -> 80               |        |
|                                    |                        |               |             | (41568)             |                  | 15              |                    |                 |             |              |               | 15                          |        |
| PB67-43001-193<br>D-Pad Base       |                        | Manufactured  | No          |                     |                  | 110             | Each               | 0.0000          | 1           | 20           |               | B111706 -> (20) 14-01-27 PD |        |
| PB67-43001-195<br>D-Pad Face       |                        | Manufactured  | No          |                     |                  | 100             | Each               | 10.0000         | 1           | 20           |               | (20) 14-01-27 PD            |        |
|                                    |                        |               |             | <u>Location</u>     |                  | <u>Loc Qty</u>  |                    | <u>Loc Code</u> |             |              |               |                             |        |
|                                    |                        |               |             | Mezz2               |                  | 10              |                    |                 |             |              |               | B111709 -> 10               |        |
|                                    |                        |               |             | (99987)             |                  | 10              |                    |                 |             |              |               | 10                          |        |
| PB67-43001-339<br>D-Pad Top        |                        | Manufactured  | No          |                     |                  | 110             | Each               | 14.0000         | 1           | 20           |               | (20) 14-01-27 PD            |        |
|                                    |                        |               |             | <u>Location</u>     |                  | <u>Loc Qty</u>  |                    | <u>Loc Code</u> |             |              |               |                             |        |
|                                    |                        |               |             | Mezz2               |                  | 14              |                    |                 |             |              |               | B111707 -> 6                |        |
|                                    |                        |               |             | (90887)             |                  | 14              |                    |                 |             |              |               | 14                          |        |

DQA: \_\_\_\_\_ Date: \_\_\_\_\_



## WORK ORDER NON-CONFORMANCE / UPDATE

QA Closed: \_\_\_\_\_ Date: \_\_\_\_\_


Work Order update only ☐

|                                                              |   |   |                                      |                                    |                                    |                                      |                                    |                                    |                                            |                                  |                                        |                                    |                                              |                                |                                    |                                    |                                   |  |
|--------------------------------------------------------------|---|---|--------------------------------------|------------------------------------|------------------------------------|--------------------------------------|------------------------------------|------------------------------------|--------------------------------------------|----------------------------------|----------------------------------------|------------------------------------|----------------------------------------------|--------------------------------|------------------------------------|------------------------------------|-----------------------------------|--|
| Work Order: _____<br><br>Part No. _____<br><br>NCR No. _____ | <b>DISPOSITION</b><br><br>Rework <input type="checkbox"/><br>Scrap <input type="checkbox"/><br>Use-as-is <input type="checkbox"/><br>Suspected Unapproved <input type="checkbox"/> | <b>AGAINST DEPARTMENT/PROCESS</b><br><br><table style="width:100%;"> <tr> <td>Skid-tube <input type="checkbox"/></td> <td>Crosstube <input type="checkbox"/></td> <td>Water Jet <input type="checkbox"/></td> <td>Engineering <input type="checkbox"/></td> </tr> <tr> <td>Machining <input type="checkbox"/></td> <td>Small Fab <input type="checkbox"/></td> <td>Prod. Eng. Coord. <input type="checkbox"/></td> <td>Quality <input type="checkbox"/></td> </tr> <tr> <td>Thermoforming <input type="checkbox"/></td> <td>Finishing <input type="checkbox"/></td> <td>Rec/Store/Packaging <input type="checkbox"/></td> <td>Other <input type="checkbox"/></td> </tr> <tr> <td>Large Fab <input type="checkbox"/></td> <td>Composite <input type="checkbox"/></td> <td>Supplier <input type="checkbox"/></td> <td></td> </tr> </table> | Skid-tube <input type="checkbox"/>   | Crosstube <input type="checkbox"/> | Water Jet <input type="checkbox"/> | Engineering <input type="checkbox"/> | Machining <input type="checkbox"/> | Small Fab <input type="checkbox"/> | Prod. Eng. Coord. <input type="checkbox"/> | Quality <input type="checkbox"/> | Thermoforming <input type="checkbox"/> | Finishing <input type="checkbox"/> | Rec/Store/Packaging <input type="checkbox"/> | Other <input type="checkbox"/> | Large Fab <input type="checkbox"/> | Composite <input type="checkbox"/> | Supplier <input type="checkbox"/> |  |
| Skid-tube <input type="checkbox"/>                           | Crosstube <input type="checkbox"/>   | Water Jet <input type="checkbox"/>   | Engineering <input type="checkbox"/> |                                    |                                    |                                      |                                    |                                    |                                            |                                  |                                        |                                    |                                              |                                |                                    |                                    |                                   |  |
| Machining <input type="checkbox"/>                           | Small Fab <input type="checkbox"/>   | Prod. Eng. Coord. <input type="checkbox"/>   | Quality <input type="checkbox"/>     |                                    |                                    |                                      |                                    |                                    |                                            |                                  |                                        |                                    |                                              |                                |                                    |                                    |                                   |  |
| Thermoforming <input type="checkbox"/>                       | Finishing <input type="checkbox"/>   | Rec/Store/Packaging <input type="checkbox"/>   | Other <input type="checkbox"/>       |                                    |                                    |                                      |                                    |                                    |                                            |                                  |                                        |                                    |                                              |                                |                                    |                                    |                                   |  |
| Large Fab <input type="checkbox"/>                           | Composite <input type="checkbox"/>   | Supplier <input type="checkbox"/>   |                                      |                                    |                                    |                                      |                                    |                                    |                                            |                                  |                                        |                                    |                                              |                                |                                    |                                    |                                   |  |


| Root Cause    | Date | Step | Qty | Description of work order update or non-conformance | Initial Chief Eng | Action Description | Sign & Date | Verification | QC Inspector |
|---------------|------|------|-----|-----------------------------------------------------|-------------------|--------------------|-------------|--------------|--------------|
| Design        |      |      |     |                                                     |                   |                    |             |              |              |
| Doc/Data      |      |      |     |                                                     |                   |                    |             |              |              |
| Equip/Tooling |      |      |     |                                                     |                   |                    |             |              |              |
| Handling/Pre  |      |      |     |                                                     |                   |                    |             |              |              |
| Material      |      |      |     |                                                     |                   |                    |             |              |              |
| Operator      |      |      |     |                                                     |                   |                    |             |              |              |
| Offset/Setup  |      |      |     |                                                     |                   |                    |             |              |              |
| Process       |      |      |     |                                                     |                   |                    |             |              |              |
| Supplier      |      |      |     |                                                     |                   |                    |             |              |              |
| Training      |      |      |     |                                                     |                   |                    |             |              |              |
| Transport     |      |      |     |                                                     |                   |                    |             |              |              |
| Unapproved    |      |      |     |                                                     |                   |                    |             |              |              |

### FAULT CATEGORY

|   |   |   |   |
|---|---|---|---|
| <b>Landing Gear</b><br><input type="checkbox"/> Bending<br><input type="checkbox"/> Centre Not Concentric<br><input type="checkbox"/> Cracks<br><input type="checkbox"/> Crimp/Kink/Ripple/Wave<br><input type="checkbox"/> Cuffs<br><input type="checkbox"/> Crushing<br><input type="checkbox"/> Heat Treat<br><input type="checkbox"/> Inspection Strip in Tube<br><input type="checkbox"/> Marks/Chatter<br><input type="checkbox"/> Turning Sequence<br><input type="checkbox"/> Wave/Twist in Tube | <b>General</b><br><input type="checkbox"/> Bend<br><input type="checkbox"/> BOM/Route<br><input type="checkbox"/> Broken/Damage/Defect<br><input type="checkbox"/> Burrs<br><input type="checkbox"/> Contamination<br><input type="checkbox"/> Countersink<br><input type="checkbox"/> Cut Too Short<br><input type="checkbox"/> Drawing<br><input type="checkbox"/> Drill Holes<br><input type="checkbox"/> Finish<br><input type="checkbox"/> Fit/Function | <input type="checkbox"/> Folio/Program<br><input type="checkbox"/> Grain<br><input type="checkbox"/> Hardware<br><input type="checkbox"/> Inspection Incomplete/Unqualified<br><input type="checkbox"/> Instructions Incomplete/Unclear<br><input type="checkbox"/> Misaligned/off center<br><input type="checkbox"/> Mislabeled<br><input type="checkbox"/> Misread<br><input type="checkbox"/> Off-set<br><input type="checkbox"/> Out of Calibration<br><input type="checkbox"/> Out of Sequence | <input type="checkbox"/> Outside Dimensions<br><input type="checkbox"/> Over/Under tolerance<br><input type="checkbox"/> Part Incorrect<br><input type="checkbox"/> Part Lost/Missing<br><input type="checkbox"/> Part Moved<br><input type="checkbox"/> Positioned Wrong<br><input type="checkbox"/> Power Loss/Surge<br><br><input type="checkbox"/> Pressure/Forced<br><input type="checkbox"/> Set-up<br><input type="checkbox"/> Temperature/Cure<br><input type="checkbox"/> Weld<br><input type="checkbox"/> Wrong Stock Pulled<br><input type="checkbox"/> Other |
|---|---|---|---|

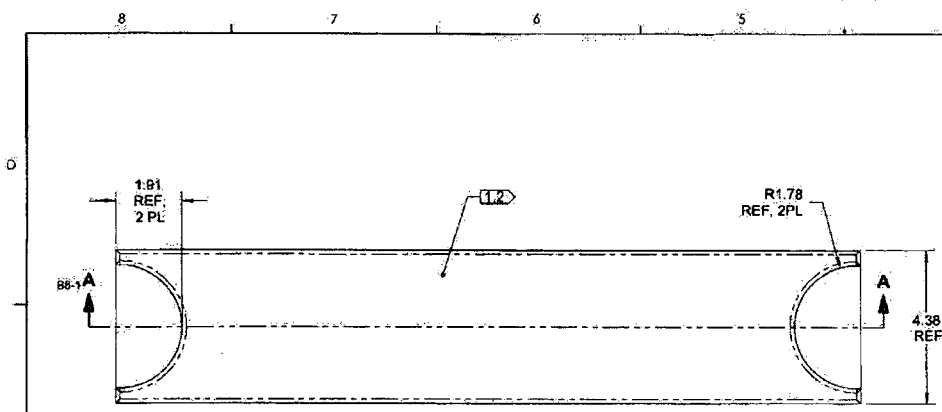


**B67-43001-173 COVER PLATE ASSEMBLY**

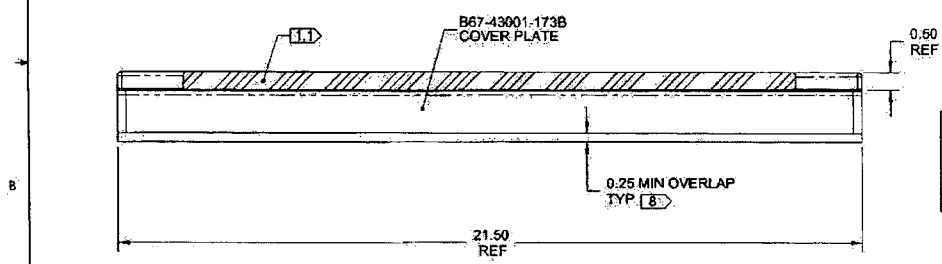

**SECTION A-A 08-1**

TULMAR MARK-UP  
REV I  
02/10/2013 RL

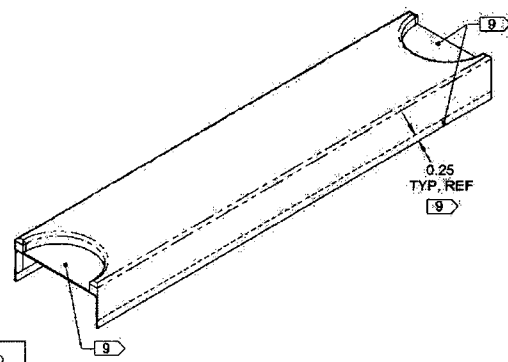

- NOTES:**
- 1) MATERIAL: FOAM, SBR/EPDM/CR BLEND, BLACK, ASTM D1056 2A2, 1/2" THK., BRITTLENESS TEMP OF -40F, IAW ASTM D 746, FMVSS 302.
  - 1.1) FOAM: ETHYLENE PROPYLENE NEOPRENE SBR CLOSED CELL, FLAME RETARDANT, 0.50 THICK, PER ASTM D1056 2A2, SERVICE TEMP -40F TO +200F, COLOUR: BLACK, REF. TULMAR P/N 1495.
  - 1.2) FABRIC: 100% 420 DENIER NYLON, MIN THREAD COUNT 35X35, POLYURETHANE COATED ONE SIDE, COLOUR: BLACK, REF. TULMAR P/N 1495.
  - 1.3) ADHESIVE: URETHANE WITH CATALYST, TWO PART, CLIFTON LA4009 OR LA4009NOVOC.
  - 2) FINISH: BOND NEOPRENE TO COVER PLATE USING ADHESIVE. COVER WITH DENIER AS SHOWN.
  - 3) TOLERANCES: PER TABLE 1 (ZN A3-1) UNLESS OTHERWISE NOTED.
  - 4) UNITS: INCHES UNLESS OTHERWISE NOTED.
  - 5) BREAK SHARP EDGES: N/A.
  - 6) IDENTIFICATION: N/A.
  - 7) WEIGHT: 0.78 lbs REF.
  - 8) DENIER NYLON TO BE BONDED ALL AROUND INNER SIDES OF PLATE.
  - 9) DENIER NYLON TO BE BONDED TO PLATE ON OUTER SIDE.


**TABLE 1** (3)

| TOLERANCES ON FABRIC (PARTS AND ASSEMBLIES) |  |
|---------------------------------------------|--|
| +1/8" DIMS <2"                              |  |
| +1/4" DIMS 2 TO <18                         |  |
| +1/2" DIMS 18 TO <20                        |  |
| +5/8" DIMS 20 TO <40                        |  |
| +1.5" DIMS EQUAL TO OR > 40                 |  |


| ITEM | QTY | P/N            | DESCRIPTION          |
|------|-----|----------------|----------------------|
| 1    | X   | B67-43001-173  | COVER PLATE ASSEMBLY |
| 2    | 1   | B67-43001-173B | COVER PLATE          |
| 3    | A/R | 1637-001       | SEE NOTE 1.1         |
| 4    | A/R | 1495           | SEE NOTE 1.2         |
| 5    | A/R | LA4009         | SEE NOTE 1.3         |

| REV.       | DESCRIPTION   | BY   | DATE     |
|------------|---|---|----------|
| C          | REDRAWN PREMIER AVIATION DRAWING IAW DART QS/018, OSI 045 AND TULMAR SAFETY SYSTEMS INC.'S MANUFACTURING PROCESS AND TOLERANCES ON FABRIC. 4.38 WAS 4.25. FOR PREVIOUS REVISIONS, REFER TO SHEETS 10 AND 27 OF PREMIER AVIATION DRAWING NO. B67-43001. REASON: SEE PAR008-011. | MB   | 10.04.27 |
| DESIGN     | RW   | <b>DART AEROSPACE LTD</b><br>HAWKESBURY, ONTARIO, CANADA<br>DRAWING NO. B67-43001-173<br>TITLE: COVER PLATE<br>COPYRIGHT © 1995 BY DART AEROSPACE LTD<br>THIS DRAWING IS THE PROPERTY OF DART AEROSPACE LTD. IT IS TO BE USED FOR THE PURPOSES SPECIFIED IN THE ORDER AND IS NOT TO BE REPRODUCED OR TRANSMITTED IN ANY FORM OR BY ANY MEANS, ELECTRONIC OR MECHANICAL, WITHOUT PERMISSION IN WRITING FROM DART AEROSPACE LTD. |          |
| DRAWN      | AS   |   |          |
| CHECKED    | AS   |   |          |
| MFG. APPR. | AS   |   |          |
| APPROVED   | AS   |   |          |
| DE APPR.   | N/A   | DATE 10.04.27   |          |

RELEASED  
2010-09-10

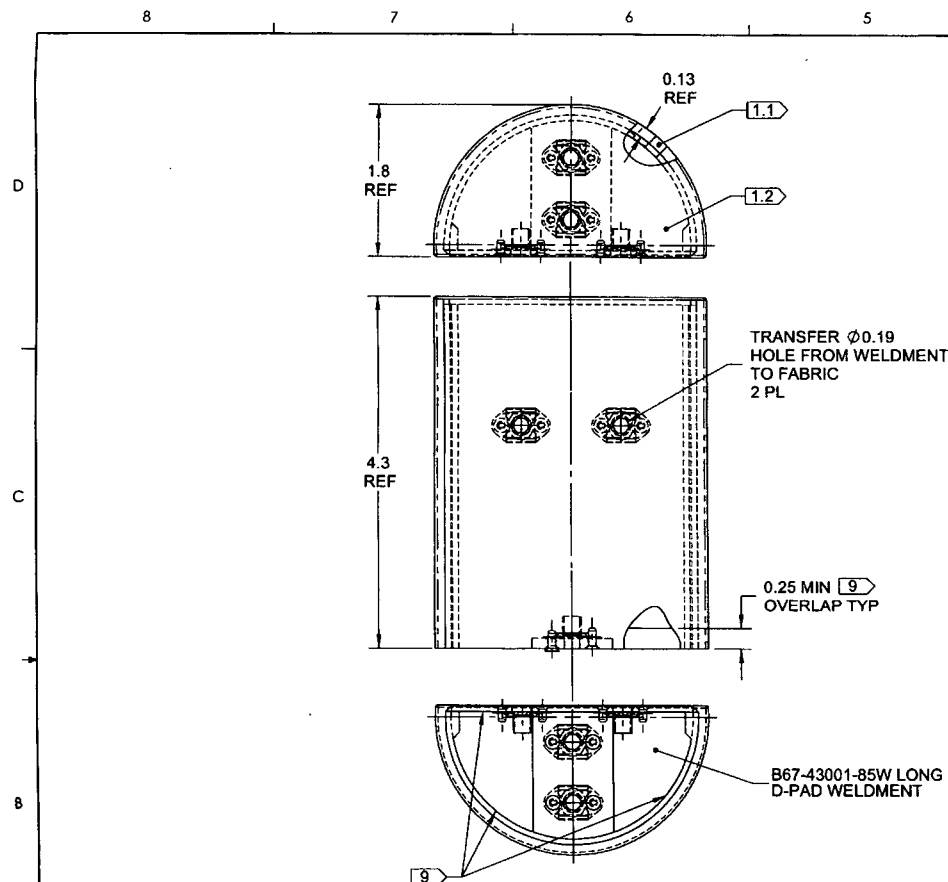

| ITEM | QTY.<br>-85 | P/N           | DESCRIPTION          |
|------|-------------|---------------|----------------------|
| 1    | X           | B67-43001-85  | D-PAD ASSEMBLY, LONG |
| 2    | 1           | B67-43001-85W | LONG D-PAD WELDMENT  |
| 3    | A/R         | 1637-002      | SEE NOTE 1.1         |
| 4    | A/R         | 1495          | SEE NOTE 1.2         |
| 5    | A/R         | LA4009        | SEE NOTE 1.3         |
| 6    | A/R         | 2530          | SEE NOTE 1.4         |

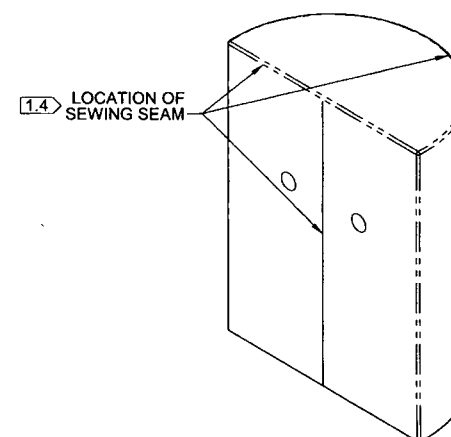

**B67-43001-85 D-PAD ASSEMBLY, LONG**

**NOTES:**

**1) MATERIAL:**

- 1.1) FOAM: ETHYLENE PROPYLENE NEOPRENE SBR CLOSED-CELL, FLAME RETARDANT, 0.125 THICK, PER ASTM D1056 2A2, SERVICE TEMP -40°F TO +200°F, COLOUR: BLACK REF. TULMAR P/N 1637-002
- 1.2) FABRIC: 100% 420 DENIER NYLON, MIN THREAD COUNT 35X35, POLYURETHANE COATED ONE SIDE, COLOUR: BLACK REF. TULMAR P/N 1495
- 1.3) ADHESIVE: URETHANE WITH CATALYST, TWO PART, CLIFTON LA4009
- 1.4) THREAD: NYLON, BLACK, V-T-295 TYPE 2, CLASS A, SIZE F, 8-10 STITCHES PER INCH REF. TULMAR P/N 2530
- 2) FINISH: BOND NEOPRENE TO COVER PLATE USING ADHESIVE. COVER WITH DENIER AS SHOWN.
- 3) TOLERANCES: PER TABLE 1 (ZN A3-1) UNLESS OTHERWISE NOTED
- 4) UNITS: INCHES UNLESS OTHERWISE NOTED
- 5) BREAK SHARP EDGES: N/A
- 6) IDENTIFICATION: N/A
- 7) WEIGHT: 0.42 lbs REF
- 8) NUTPLATES AD HOLES MUST REMAIN FREE OF ADHESIVE AND FABRIC
- 9) DENIER NYLON TO OVERLAP BY 0.25 MIN AND BE BONDED ALL AROUND INNER SIDES OF PLATE

**TABLE 1**

| TOLERANCES ON FABRIC<br>(PARTS AND ASSEMBLIES) |
|------------------------------------------------|
| ±1/8: DIMS <2                                  |
| ±1/4: DIMS 2 TO <10                            |
| ±1/2: DIMS 10 TO <20                           |
| ±5/8: DIMS 20 TO <40                           |
| ±1.5%: DIMS EQUAL TO OR > 40                   |

| C   | REDRAWN PREMIER AVIATION DRAWING IAW DART QSI 018, QSI 043 AND TULMAR SAFETY SYSTEMS INC.'S MANUFACTURING PROCESS AND TOLERANCES ON FABRIC. FOR PREVIOUS REVISIONS, REFER TO SHEET 12 OF PREMIER AVIATION DRAWING No. B67-43001. REASON: SEE PAR#09-011. | MB | 10.04.27 |
|---|---|----|----------|
| REV.   | DESCRIPTION   | BY | DATE     |
| DESIGN   | RW   |    |          |
| DRAWN   | A   |    |          |
| CHECKED   | JP   |    |          |
| MFG. APPR.   | MS   |    |          |
| APPROVED   |   |    |          |
| DE APPR.   | N/A   |    |          |
| DATE   | 10.04.27   |    |          |
| <b>DART AEROSPACE LTD</b><br>HAWKESBURY, ONTARIO, CANADA<br>DRAWING NO. B67-43001-85<br>TITLE D-PAD ASSEMBLY, LONG<br>SCALE NTS<br>COPYRIGHT © 1996 BY DART AEROSPACE LTD<br>THIS DOCUMENT IS PRIVATE AND CONFIDENTIAL AND IS SUPPLIED ON THE EXPRESS CONDITION THAT IT IS NOT TO BE USED FOR ANY PURPOSE OR COPIED OR COMMUNICATED TO ANY OTHER PERSON WITHOUT WRITTEN PERMISSION FROM DART AEROSPACE LTD. |   |    |          |

**RELEASED**  
2010-09-16

*mk*  
*#111756*  
*14-1-21*

DQA: \_\_\_\_\_ Date: \_\_\_\_\_



## WORK ORDER NON-CONFORMANCE / UPDATE

QA Closed: \_\_\_\_\_ Date: \_\_\_\_\_




Work Order update only ☐

|                                                              |   |   |                                      |                                    |                                    |                                      |                                    |                                    |                                            |                                  |                                        |                                    |                                              |                                |                                    |                                    |                                   |  |
|--------------------------------------------------------------|---|---|--------------------------------------|------------------------------------|------------------------------------|--------------------------------------|------------------------------------|------------------------------------|--------------------------------------------|----------------------------------|----------------------------------------|------------------------------------|----------------------------------------------|--------------------------------|------------------------------------|------------------------------------|-----------------------------------|--|
| Work Order: _____<br><br>Part No. _____<br><br>NCR No. _____ | <b>DISPOSITION</b><br><br>Rework <input type="checkbox"/><br>Scrap <input type="checkbox"/><br>Use-as-is <input type="checkbox"/><br>Suspected Unapproved <input type="checkbox"/> | <b>AGAINST DEPARTMENT/PROCESS</b><br><br><table style="width:100%;"> <tr> <td>Skid-tube <input type="checkbox"/></td> <td>Crosstube <input type="checkbox"/></td> <td>Water Jet <input type="checkbox"/></td> <td>Engineering <input type="checkbox"/></td> </tr> <tr> <td>Machining <input type="checkbox"/></td> <td>Small Fab <input type="checkbox"/></td> <td>Prod. Eng. Coord. <input type="checkbox"/></td> <td>Quality <input type="checkbox"/></td> </tr> <tr> <td>Thermoforming <input type="checkbox"/></td> <td>Finishing <input type="checkbox"/></td> <td>Rec/Store/Packaging <input type="checkbox"/></td> <td>Other <input type="checkbox"/></td> </tr> <tr> <td>Large Fab <input type="checkbox"/></td> <td>Composite <input type="checkbox"/></td> <td>Supplier <input type="checkbox"/></td> <td></td> </tr>





| Root Cause    | Date | Step | Qty | Description of work order update or non-conformance | Initial Chief Eng | Action Description | Sign & Date | Verification | QC Inspector |
|---------------|------|------|-----|-----------------------------------------------------|-------------------|--------------------|-------------|--------------|--------------|
| Design        |      |      |     |                                                     |                   |                    |             |              |              |
| Doc/Data      |      |      |     |                                                     |                   |                    |             |              |              |
| Equip/Tooling |      |      |     |                                                     |                   |                    |             |              |              |
| Handling/Pre  |      |      |     |                                                     |                   |                    |             |              |              |
| Material      |      |      |     |                                                     |                   |                    |             |              |              |
| Operator      |      |      |     |                                                     |                   |                    |             |              |              |
| Offset/Setup  |      |      |     |                                                     |                   |                    |             |              |              |
| Process       |      |      |     |                                                     |                   |                    |             |              |              |
| Supplier      |      |      |     |                                                     |                   |                    |             |              |              |
| Training      |      |      |     |                                                     |                   |                    |             |              |              |
| Transport     |      |      |     |                                                     |                   |                    |             |              |              |
| Unapproved    |      |      |     |                                                     |                   |                    |             |              |              |

### FAULT CATEGORY

|   |   |   |
|---|---|---|
| <b>Landing Gear</b><br><input type="checkbox"/> Bending<br><input type="checkbox"/> Centre Not Concentric<br><input type="checkbox"/> Cracks<br><input type="checkbox"/> Crimp/Kink/Ripple/Wave<br><input type="checkbox"/> Cuffs<br><input type="checkbox"/> Crushing<br><input type="checkbox"/> Heat Treat<br><input type="checkbox"/> Inspection Strip in Tube<br><input type="checkbox"/> Marks/Chatter<br><input type="checkbox"/> Turning Sequence<br><input type="checkbox"/> Wave/Twist in Tube | <b>General</b><br><input type="checkbox"/> Bend<br><input type="checkbox"/> BOM/Route<br><input type="checkbox"/> Broken/Damage/Defect<br><input type="checkbox"/> Burrs<br><input type="checkbox"/> Contamination<br><input type="checkbox"/> Countersink<br><input type="checkbox"/> Cut Too Short<br><input type="checkbox"/> Drawing<br><input type="checkbox"/> Drill Holes<br><input type="checkbox"/> Finish<br><input type="checkbox"/> Fit/Function | <input type="checkbox"/> Folio/Program<br><input type="checkbox"/> Grain<br><input type="checkbox"/> Hardware<br><input type="checkbox"/> Inspection Incomplete/Unqualified<br><input type="checkbox"/> Instructions Incomplete/Unclear<br><input type="checkbox"/> Misaligned/off center<br><input type="checkbox"/> Mislabeled<br><input type="checkbox"/> Misread<br><input type="checkbox"/> Off-set<br><input type="checkbox"/> Out of Calibration<br><input type="checkbox"/> Out of Sequence |
|   |   | <input type="checkbox"/> Outside Dimensions<br><input type="checkbox"/> Over/Under tolerance<br><input type="checkbox"/> Part Incorrect<br><input type="checkbox"/> Part Lost/Missing<br><input type="checkbox"/> Part Moved<br><input type="checkbox"/> Positioned Wrong<br><input type="checkbox"/> Power Loss/Surge   |
|   |   | <input type="checkbox"/> Pressure/Forced Set-up<br><input type="checkbox"/> Temperature/Cure<br><input type="checkbox"/> Weld<br><input type="checkbox"/> Wrong Stock Pulled<br><input type="checkbox"/> Other   |

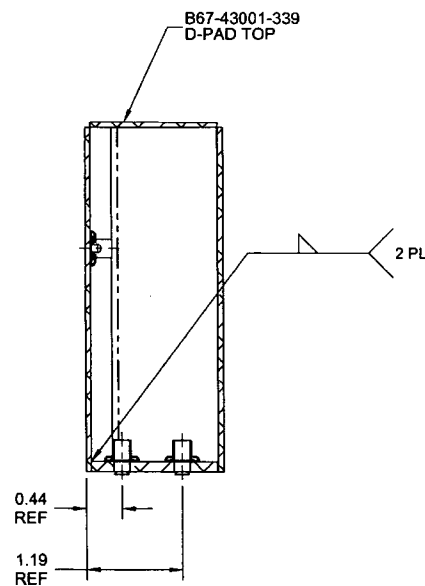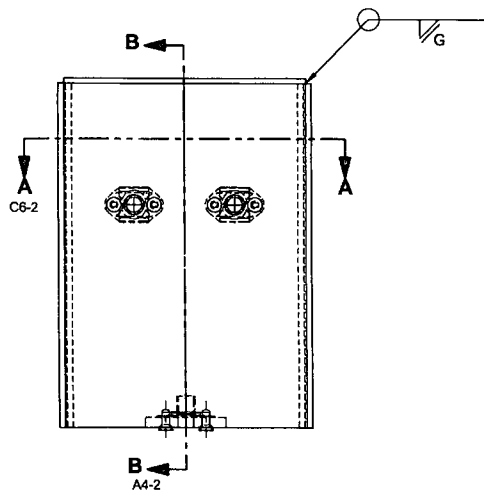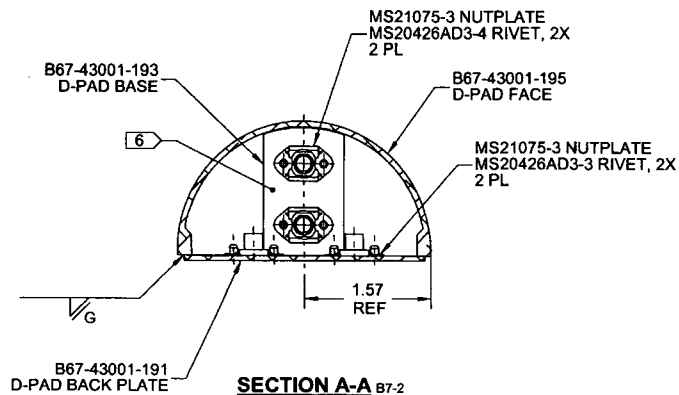

| ITEM | QTY<br>-85W | P/N           | DESCRIPTION         |
|------|-------------|---------------|---------------------|
| 1    | X           | B67-43001-85W | LONG D-PAD WELDMENT |
| 2    | 1           | B67-43001-191 | D-PAD BACK PLATE    |
| 3    | 1           | B67-43001-193 | D-PAD BASE          |
| 4    | 1           | B67-43001-195 | D-PAD FACE          |
| 5    | 1           | B67-43001-339 | D-PAD TOP           |
| 6    | 4           | MS20426AD3-3  | RIVET               |
| 7    | 4           | MS20426AD3-4  | RIVET               |
| 8    | 4           | MS21075L3     | NUT PLATE           |

- NOTES:**
- 1) MATERIAL: NONE
  - 2) FINISH: POWDER COAT GREEN SANDTEX (4.3.5.8) PER DART QSI 005 4.3
  - 3) TOLERANCES: PER DART QSI 018 UNLESS OTHERWISE NOTED
  - 4) UNITS: INCHES UNLESS OTHERWISE NOTED
  - 5) BREAK SHARP EDGES: 0.005 TO 0.010 MAX
  - 6) IDENTIFICATION: IDENTIFY WITH DART P/N "B67-43001-85W" AND B/N "BXXXXX" USING FINE POINT PERMANENT INK MARKER
  - 7) WEIGHT: 0.42 lbs
  - 8) WELDING: PER DART QSI 004

|   |                                                                                       |                                        |              |
|---|---------------------------------------------------------------------------------------|----------------------------------------|--------------|
| DESIGN   | RW                                                                                    | <b>DART AEROSPACE LTD</b>              |              |
| DRAWN   |  | HAWKESBURY, ONTARIO, CANADA            |              |
| CHECKED   |  | DRAWING NO.                            | REV. C       |
| MFG. APPR.   |  | B67-43001-85                           | SHEET 2 OF 2 |
| APPROVED   |  | TITLE                                  | SCALE        |
| DE APPR.   | N/A                                                                                   | D-PAD ASSEMBLY, LONG                   | NTS          |
| DATE   | 10.04.27                                                                              | COPYRIGHT © 1995 BY DART AEROSPACE LTD |              |
| THIS DOCUMENT IS PRIVATE AND CONFIDENTIAL AND IS SUPPLIED ON THE EXPRESS CONDITION THAT IT IS NOT TO BE USED FOR ANY PURPOSE OR COPIED OR COMMUNICATED TO ANY OTHER PERSON WITHOUT WRITTEN PERMISSION FROM DART AEROSPACE LTD. |                                                                                       |                                        |              |

RELEASED  
2010-09-16

DQA: \_\_\_\_\_ Date: \_\_\_\_\_



## WORK ORDER NON-CONFORMANCE / UPDATE

QA Closed: \_\_\_\_\_ Date: \_\_\_\_\_

Work Order update only ☐




|                                                              |   |   |                                      |                                    |                                    |                                      |                                    |                                    |                                            |                                  |                                        |                                    |                                              |                                |                                    |                                    |                                   |  |
|--------------------------------------------------------------|---|---|--------------------------------------|------------------------------------|------------------------------------|--------------------------------------|------------------------------------|------------------------------------|--------------------------------------------|----------------------------------|----------------------------------------|------------------------------------|----------------------------------------------|--------------------------------|------------------------------------|------------------------------------|-----------------------------------|--|
| Work Order: _____<br><br>Part No. _____<br><br>NCR No. _____ | <b>DISPOSITION</b><br><br>Rework <input type="checkbox"/><br>Scrap <input type="checkbox"/><br>Use-as-is <input type="checkbox"/><br>Suspected Unapproved <input type="checkbox"/> | <b>AGAINST DEPARTMENT/PROCESS</b><br><br><table style="width: 100%;"> <tr> <td>Skid-tube <input type="checkbox"/></td> <td>Crosstube <input type="checkbox"/></td> <td>Water Jet <input type="checkbox"/></td> <td>Engineering <input type="checkbox"/></td> </tr> <tr> <td>Machining <input type="checkbox"/></td> <td>Small Fab <input type="checkbox"/></td> <td>Prod. Eng. Coord. <input type="checkbox"/></td> <td>Quality <input type="checkbox"/></td> </tr> <tr> <td>Thermoforming <input type="checkbox"/></td> <td>Finishing <input type="checkbox"/></td> <td>Rec/Store/Packaging <input type="checkbox"/></td> <td>Other <input type="checkbox"/></td> </tr> <tr> <td>Large Fab <input type="checkbox"/></td> <td>Composite <input type="checkbox"/></td> <td>Supplier <input type="checkbox"/></td> <td></td> </tr>





| Root Cause    | Date | Step | Qty | Description of work order update or non-conformance | Initial Chief Eng | Action Description | Sign & Date | Verification | QC Inspector |
|---------------|------|------|-----|-----------------------------------------------------|-------------------|--------------------|-------------|--------------|--------------|
| Design        |      |      |     |                                                     |                   |                    |             |              |              |
| Doc/Data      |      |      |     |                                                     |                   |                    |             |              |              |
| Equip/Tooling |      |      |     |                                                     |                   |                    |             |              |              |
| Handling/Pre  |      |      |     |                                                     |                   |                    |             |              |              |
| Material      |      |      |     |                                                     |                   |                    |             |              |              |
| Operator      |      |      |     |                                                     |                   |                    |             |              |              |
| Offset/Setup  |      |      |     |                                                     |                   |                    |             |              |              |
| Process       |      |      |     |                                                     |                   |                    |             |              |              |
| Supplier      |      |      |     |                                                     |                   |                    |             |              |              |
| Training      |      |      |     |                                                     |                   |                    |             |              |              |
| Transport     |      |      |     |                                                     |                   |                    |             |              |              |
| Unapproved    |      |      |     |                                                     |                   |                    |             |              |              |

### FAULT CATEGORY

|   |   |   |   |
|---|---|---|---|
| <b>Landing Gear</b><br><input type="checkbox"/> Bending<br><input type="checkbox"/> Centre Not Concentric<br><input type="checkbox"/> Cracks<br><input type="checkbox"/> Crimp/Kink/Ripple/Wave<br><input type="checkbox"/> Cuffs<br><input type="checkbox"/> Crushing<br><input type="checkbox"/> Heat Treat<br><input type="checkbox"/> Inspection Strip in Tube<br><input type="checkbox"/> Marks/Chatter<br><input type="checkbox"/> Turning Sequence<br><input type="checkbox"/> Wave/Twist in Tube | <b>General</b><br><input type="checkbox"/> Bend<br><input type="checkbox"/> BOM/Route<br><input type="checkbox"/> Broken/Damage/Defect<br><input type="checkbox"/> Burrs<br><input type="checkbox"/> Contamination<br><input type="checkbox"/> Countersink<br><input type="checkbox"/> Cut Too Short<br><input type="checkbox"/> Drawing<br><input type="checkbox"/> Drill Holes<br><input type="checkbox"/> Finish<br><input type="checkbox"/> Fit/Function | <input type="checkbox"/> Folio/Program<br><input type="checkbox"/> Grain<br><input type="checkbox"/> Hardware<br><input type="checkbox"/> Inspection Incomplete/Unqualified<br><input type="checkbox"/> Instructions Incomplete/Unclear<br><input type="checkbox"/> Misaligned/off center<br><input type="checkbox"/> Mislabeled<br><input type="checkbox"/> Misread<br><input type="checkbox"/> Off-set<br><input type="checkbox"/> Out of Calibration<br><input type="checkbox"/> Out of Sequence | <input type="checkbox"/> Outside Dimensions<br><input type="checkbox"/> Over/Under tolerance<br><input type="checkbox"/> Part Incorrect<br><input type="checkbox"/> Part Lost/Missing<br><input type="checkbox"/> Part Moved<br><input type="checkbox"/> Positioned Wrong<br><input type="checkbox"/> Power Loss/Surge<br><br><input type="checkbox"/> Pressure/Forced Set-up<br><input type="checkbox"/> Temperature/Cure<br><input type="checkbox"/> Weld<br><input type="checkbox"/> Wrong Stock Pulled<br><input type="checkbox"/> Other |
|---|---|---|---|


| ITEM | QTY. | P/N           | DESCRIPTION          |
|------|------|---------------|----------------------|
| 1    | X    | B67-43001-85  | D-PAD ASSEMBLY, LONG |
| 2    | 1    | B67-43001-85W | LONG D-PAD WELDMENT  |
| 3    | A/R  | 1637-002      | SEE NOTE 1.1         |
| 4    | A/R  | 1485          | SEE NOTE 1.2         |
| 5    | A/R  | LA4009        | SEE NOTE 1.3         |
| 6    | A/R  | 2530          | SEE NOTE 1.4         |

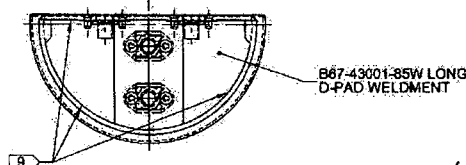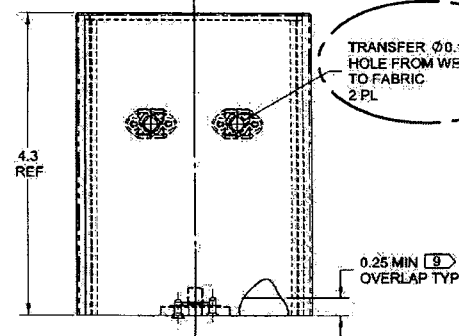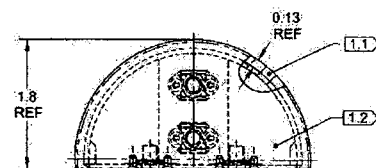

THE TWO 0.19" DIA. HOLES ARE TO BE DONE BY DART.

TRANSFER Ø0.19 HOLE FROM WELDMENT TO FABRIC 2 PL

1.4 LOCATION OF SEWING SEAM

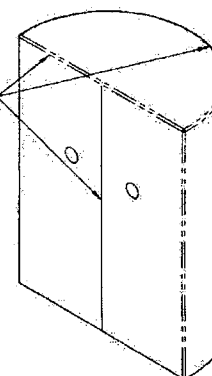

TULMAR MARK-UP  
REV 2  
03/06/2013 RL

B67-43001-85 D-PAD ASSEMBLY, LONG

# NOTES:

- 1) MATERIAL:
  - 1.1) FOAM: ETHYLENE-PROPYLENE-NEOPRENE SBR CLOSED CELL, FLAME RETARDANT, 0.125 THK., PER ASTM D1056 2A2, SERVICE TEMP -40 F TO +200 F, COLOUR: BLACK, REF: TULMAR P/N 1637-002
  - 1.2) FABRIC: 100% 420 DENIER NYLON, MIN THREAD COUNT 35X35, POLYURETHANE COATED ONE SIDE, COLOUR: BLACK, REF: TULMAR P/N 1485
  - 1.3) ADHESIVE: URETHANE WITH CATALYST, TWO PART, CLIFTON LA4009 OR LA4009NOVOC.
  - 1.4) THREAD: NYLON, BLACK, V-T-208 TYPE 2, CLASS A, SIZE F, 8-10 STITCHES PER INCH, REF: TULMAR P/N 2530
- 2) FINISH: BOND NEOPRENE TO COVER PLATE USING ADHESIVE. COVER WITH DENIER AS SHOWN.
- 3) TOLERANCES: PER TABLE 1 (ZN A3-1) UNLESS OTHERWISE NOTED.
- 4) UNITS: INCHES UNLESS OTHERWISE NOTED.
- 5) BREAK SHARP EDGES: N/A
- 6) IDENTIFICATION: N/A
- 7) WEIGHT: 0.42 lbs REF
- 8) NUTPLATES AND HOLES MUST REMAIN FREE OF ADHESIVE AND FABRIC.
- 9) DENIER NYLON TO OVERLAP BY 0.25 MIN AND BE BONDED ALL AROUND INNER SIDES OF PLATE




TABLE 1

| TOLERANCES ON FABRIC (PARTS AND ASSEMBLIES) |
|---------------------------------------------|
| ± 1/8% DIMS < 2                             |
| ± 1/4% DIMS 2 TO < 10                       |
| ± 1/2% DIMS 10 TO < 20                      |
| ± 3/8% DIMS 20 TO < 40                      |
| ± 1.5% DIMS EQUAL TO OR > 40                |

|   |             |   |      |
|---|-------------|---|------|
| C   |             | REDRAWN PREMIER AVIATION DRAWING IAW DART QSI 018, QSI 043 AND TULMAR SAFETY SYSTEMS INC'S MANUFACTURING PROCESS AND TOLERANCES ON FABRIC. FOR PREVIOUS REVISIONS, REFER TO SHEET 1.2 OF PREMIER AVIATION DRAWING No. B67-43001, REASON: SEE PART 09-011. |      |
| REV.   | DESCRIPTION | BY   | DATE |
| DESIGN   | RTV         |   |      |
| DRAWN   |             |   |      |
| CHECKED   |             |   |      |
| MFG. APPR.   |             |   |      |
| APPROVED   |             |   |      |
| DE APPR.   | N/A         |   |      |
| DATE   | 10.04.27    |   |      |
| <b>DART AEROSPACE LTD</b><br>HAWKESBURY, ONTARIO, CANADA<br>DRAWING NO. <b>B67-43001-85</b><br>TITLE <b>D-PAD ASSEMBLY, LONG</b><br>SCALE <b>NTS</b><br>SHEET 1 OF 2<br>REV. C |             |   |      |

RELEASED  
2010-09-18



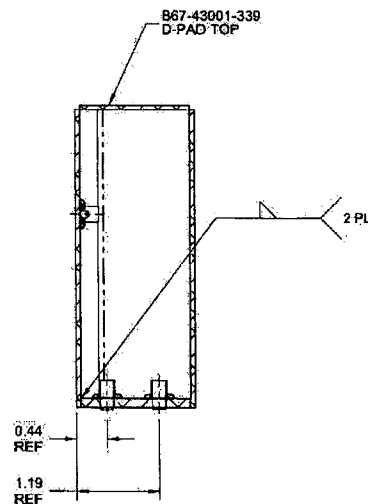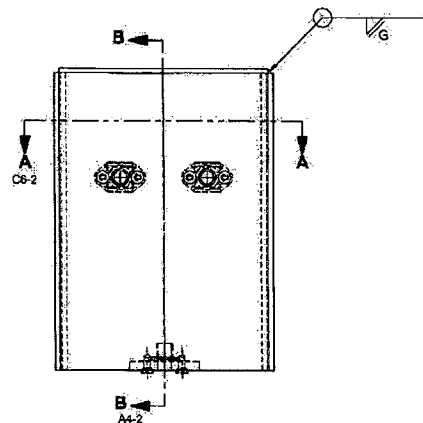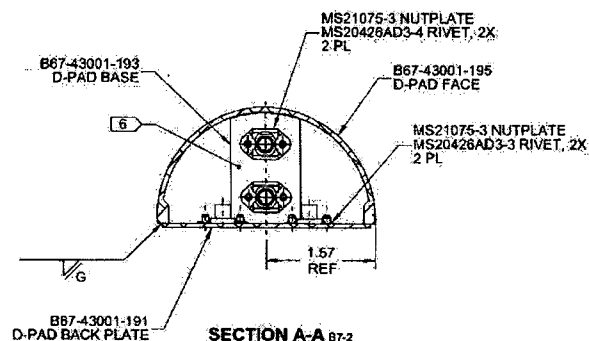


| ITEM | QTY | P/N           | DESCRIPTION         |
|------|-----|---------------|---------------------|
| 1    | X   | B67-43001-85W | LONG D-PAD WELDMENT |
| 2    | 1   | B67-43001-191 | D-PAD BACK PLATE    |
| 3    | 1   | B67-43001-193 | D-PAD BASE          |
| 4    | 1   | B67-43001-195 | D-PAD FACE          |
| 5    | 1   | B67-43001-339 | D-PAD TOP           |
| 6    | 4   | MS20426AD3-3  | RIVET               |
| 7    | 4   | MS20426AD3-4  | RIVET               |
| 8    | 4   | MS21075L3     | NUT PLATE           |

RELEASED  
2010-09-16

- NOTES:
- 1) MATERIAL: NONE
  - 2) FINISH: POWDER COAT GREEN SANDTEX (4.3.5.8) PER DART QSI 005 4.3
  - 3) TOLERANCES: PER DART QSI 018 UNLESS OTHERWISE NOTED
  - 4) UNITS: INCHES UNLESS OTHERWISE NOTED
  - 5) BREAK SHARP EDGES: 0.005 TO 0.010 MAX
  - 6) IDENTIFICATION: IDENTIFY WITH DART P/N "B67-43001-85W" AND B/N "BXXXXX" USING FINE POINT PERMANENT INK MARKER
  - 7) WEIGHT: 0.42 lbs
  - 8) WELDING: PER DART QSI 004

|            |          |   |              |
|------------|----------|---|--------------|
| DESIGN     | R/V      | DART AEROSPACE LTD   |              |
| DRAWN      |          | HAWKESBURY, ONTARIO, CANADA   |              |
| CHECKED    |          | DRAWING NO.   | REV. C       |
| MFG. APPR. |          | B67-43001-85   | SHEET 2 OF 2 |
| APPROVED   |          | TITLE   | SCALE        |
| DE APPR.   | N/A      | D-PAD ASSEMBLY, LONG   | NTS          |
|              |

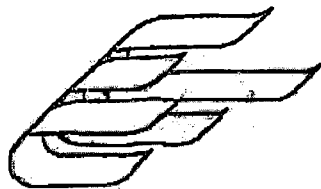

# J. ENNIS FABRICS

October 7, 2013

Fax To: Tulmar Safety Systems  
Fax: 613-632-2030  
Attention: Meagan

Certificate of Conformance

Re: PO 26380-00 for Oxford 7 Black

The goods shipped on P/O 26380-00 are as per sampled goods. Specification as follows:  
As per mill documentation:

**Oxford 7 Black** is in compliance with the following standards:

**Width:** Product is 58 Inches Wide.

**Roll Size:** Average Roll Length is 75 Yards.

**Weight:** Product Weight is 6.79 Ounces per Sq.Yd. /Product Weight is 10.94 oz per Lin.Yd

**Content:** 100% Nylon

**Coating:** Product has a Polyurethane Coating (approximately 0.65 oz/ Sq.Yd. (18.5g/sq.yd.))

**Denier:** Yarn is 420 Denier.

**Thread Count:** Construction is 62 x 38 Threads per Square Inch

**Protective Finish:** Product is Water Repellent.

**Hydro Resist:** AATCC 127 (Suter): Average 800 mm

**Piece # Various Manufacture Date:** 05/17/13, Lot Number: 422038

Sincerely,  
J. Ennis Fabrics Ltd.

*C. Harris*

Crystal Harris  
Customer Service Specialist

TSS → 8421-102

DWG B67-43001-85+MU

1495/29.

SN

|                  |                                                               |                 |                                          |
|------------------|---------------------------------------------------------------|-----------------|------------------------------------------|
| E.F. Walter Inc. | <b>CERTIFICAT DE CONFORMITÉ<br/>CERTIFICATE OF COMPLIANCE</b> |                 | Approved <u>JB</u><br>Date <u>1/3/02</u> |
| Revision # 0     | Revision date: January 30, 2002                               | Doc # F.7.5.5.A | Page 1 of 1                              |

Date : 04/14/2009VENDU À  
SOLD TO6048

TULMAR SAFETY SYSTEMS INC.  
1123 CAMERON STREET  
HAWKESBURY ONT  
K6A 2B8

FOURNISSEUR  
VENDOR

E.F. WALTER INC.  
180 BARTOR ROAD  
TORONTO, ONTARIO  
M9M 2W6

Commande / Order # 15534-00  
 Notre / Our Reference # 59448

Nous certifions par la présente que la totalité du matériel inscrit ci-dessous a été inspecté et vérifié et est conforme aux devis et aux normes mentionnés sur votre commande.

We hereby certify that all of the material listed below has been inspected and tested and conforms to the drawings and / or specifications stated on your purchase order.

| Item      | Quantité<br>Quantity | Pièce #<br>Part # | Description                                         |
|-----------|----------------------|-------------------|-----------------------------------------------------|
| 742012007 | 15 sheets            | 1637-002          | SC 42 BLACK - TRIMMED - NO SKIN 1/8" TH X 42" X 72" |
|           |                      |                   |                                                     |
|           |                      |                   | LOT# 84277 MFG DATE: 03/22/09                       |
|           |                      |                   |                                                     |
|           |                      |                   |                                                     |
Signé  
Signed

TSS # 1637-602/02

# Purchase order

# TULMAR

PO number

**15534-00**

The P.O. Number must appear on all related correspondence, shipping papers and invoices.

PO date

25-Feb-2009

Page

Page 1 of 1

Order type

Normal

Release

Tulmar Safety Systems Inc.  
1123 Cameron Street  
Hawkesbury, ON K6A 2B8  
Canada  
PST 6879 7176  
Tel: 613-632-1282  
Fax: 613-632-2030  
lori@tulmar.com

*Attn: Susan*

*Mar 19/09*

## Ordered From

E.F. Walter Inc.  
5000 Hickmore St.  
Montreal, QC:H4T 1K6  
Canada  
Tony Fata  
514-735-5351

## Ship to

Tulmar Safety Systems Inc.  
1123 Cameron Street  
Hawkesbury, ON K6A 2B8  
CA

| Buyer       |                       | Terms       |   | Ack / Con        | FOB        | Ship via        | PPD/COL   |
|-------------|-----------------------|-------------|---|------------------|------------|-----------------|-----------|
| Lori Morris |                       | Net 30 Days |   | Yes Yes          | Origin     | Call When Ready | Collect   |
| Line        | Qty Ordered           | UOM         | Our Item Number/Description   | Your Item Number | Unit price | Extended Price  | Requested |
| 1           | <i>April 13/09 15</i> | SH          | 1637-002<br>Foam,SBR Closed-Cell,<br>ASTM D1056 2A2, 1/8"x42"x72"<br><br>Ethylene propylene neoprene<br>Flame retardant, service temp<br>-40°F to +200°F |                  | 23.7600    | 356.40          | 2/26/2009 |

*I changed the price to match the  
"Trimmed" sheet pricing.*


*Thank you.*

**Total Extended Price CAD = 356.40**  
**Total Applicable Taxes = 17.82**

## Comments

**C OF C must be INSIDE shipment**

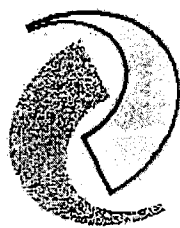

**ROYAL****ADHESIVES & SEALANTS, LLC***Aerospace & Marine Inflatable Adhesives & Coatings Division*

Date: 11/18/13

LA4009

Shipper #: 755

**Certificate of Compliance**

This letter certifies that 110 x 1 gallon cans of LA4009 Polyurethane Adhesive,

**\*\*Drawing No: (Ref 10557979)**

lot number: PNJ-1113-041 was shipped to you on 11/18/13. **\*\*DWG REV: "A" Royal Adhesive & Sealants,**

LLC - Aerospace & Marine Inflatable Adhesives & Coatings Division manufactured this material according to internal specifications which include quality control and assurance procedures. The material was manufactured on 10/22/13 against your Purchase Order # 26618.

Shelf Life: 1 year from date of manufacture

Expiration Date: 10/22/14

This letter certifies that 19 x quart cans of CATUV Accelerator, Lot number PNJ-1113-040 was shipped to you

on 11/18/13. Royal Adhesive & Sealants, LLC - Aerospace & Marine Inflatable Adhesives & Coatings

Division manufactured this material according to internal specifications which include quality control and assurance procedures. The material was manufactured on 11/14/13 against your Purchase Order # 26618.

Shelf Life: 1 year from date of manufacture

Expiration Date: 11/14/14

Sincerely,

*Dan Constantino*

Daniel Constantino

TSS 7122/59 (52)

**Royal Adhesives & Sealants, LLC - Aerospace & Marine Inflatable Adhesives & Coatings Division**  
**48 Burgess Place Wayne, New Jersey 07470 Phone: 973-694-0845 Fax: 973-694-5678**

TSS 7122-501/10 (82)

# PACKING SLIP

# TULMAR

Tulmar Safety Systems Inc.  
1123 Cameron Street  
Hawkesbury, ON K6A 2B8 CA  
Tel: 613-632-1282  
Fax: 613-632-2030  
MID: XOTULSAF1123HAW  
email: info@tulmar.com

Packing Slip No.

**51450**

Ship Date

26-Mar-14

Bill To:

**Dart Aerospace**

1270 Aberdeen Street

Hawkesbury, ON K6A 1K7. Canada

Ship to:

**Dart Aerospace**

1270 Aberdeen Street

Tel: 613-632-9577

Att: Chantal Lavoie

Hawkesbury, ON K6A 1K7. Canada

|                     |                         |                       |                               |
|---------------------|-------------------------|-----------------------|-------------------------------|
| <b>Order number</b> | <b>Sales order date</b> | <b>Account number</b> | <b>Account manager</b>        |
| 31538               | 4-Feb-14                | CDART100              | Helena Vandeweerd             |
| <b>PO number</b>    | <b>Ship Via</b>         | <b>Shipping Terms</b> |                               |
| PO22870             | Pick-Up                 | FOB HAWKESBURY        |                               |
| <b>Item No.</b>     | <b>Quantity ordered</b> | <b>UOM</b>            | <b>Qty Shipped/Returned</b>   |
| <b>Description</b>  |                         |                       | <b>Quantity on back order</b> |

QA-A027 waived

Note = Foam & Fabric as per Dwg

8421-102

20 ✓

EA

20

D-Pad Assembly, Long/

Drawing No: B67-43001-85+MU

DWG Rev: C+2

A004 A005 A007 A016 A026 A040 A041

**Lot No:** BATCH0000000009 Qty: 20

8421-101

60 ✓

EA

60

D-Pad Assembly, Short/

Drawing No: B67-43001-83+MU

DWG Rev: C+1

A004 A005 A007 A016 A026 A040 A041

**Lot No:** BATCH0000000011 Qty: 60

SP14-3-27

Shipper

*[Signature]*

Date:

MAR 26 2014

## Certificate of Conformance

☒ See Certification Enclosed

I hereby certify that the items listed hereon have been inspected, and / or tested (as applicable), conform to all specifications and requirements detailed in the contract or purchase order. Objective evidence to support this statement is on file, and can be made available upon request.

If any questions or concerns, please contact QA Manager @ 613-632-1282 ext. 245.

Authorized Inspector

*[Signature: Lorraine LaLiberte]*

Date:

MAR 26 2014



Dart Aerospace Ltd.  
1270 Aberdeen Street  
Hawkesbury, ON K6A 1K7  
Tel: 613 632 9577  
Fax: 613 632 1053

## PURCHASE ORDER

Purchase Order ID PO22870

Purchase Order Date 2/3/2014

PO Print Date 3/7/2014

Page Number 1 of 2

Order From :  
TULMAR SAFETY SYSTEMS  
1123 CAMERON ST  
HAWKESBURY, ON K6A 2B8  
CA

VC-TUL001

Ship To : DART AEROSPACE LTD  
1270 ABERDEEN  
HAWKESBURY, ON K6A 1K7  
CANADA

*REVISED*

Contact Name  
Vendor Phone 613 632 1282  
  
Ship To Contact  
Ship To Phone  
Ship Via: VENDOR'S TRUCK  
Ship Acct:

Buyer  
Customer POID  
Customer Tax # 10127-2607  
Terms Net 30  
Currency CAD  
FOB FCA - (Free Carrier)

| Line Nbr | Reference Vendor Part Number | Description/ Mfg ID | Req Date/ Taxable | CD | Req Qty/ Unit of Measure | PO Unit Price | Extend Pri |
|----------|------------------------------|---------------------|-------------------|----|--------------------------|---------------|------------|
|----------|------------------------------|---------------------|-------------------|----|--------------------------|---------------|------------|

*[Signature]*

PB67-43001-173 COVER  
PLATE

2/26/2014

20.00

\$130.00

\$2,600.

Yes

3/28/2014

FOAM AND FABRIC AS PER DWG *REV.C+1*

NOTE: ACCEPTABLE DEVIATION PART ARE NOT AIRWORTHY

FOAM, SBR/EPDM/CR BLEND BLACK, ASTM D1056 2A2, 1/2" THK BRITTLNESS TEMP. OF-40F, IAW ASTM D 746, FMVSS 302  
ADHESIVE: LA4009NOVOC

Line Total: \$2,600.

*[Signature]*  
2 111756

PB67-43001-85 D-PAD  
ASSEMBLY, LONG

2/26/2014

20.00 ✓

\$50.00

\$1,000.

Yes

3/28/2014

FOAM AND FABRIC AS PER DWG *REV.C+2*

NOTE: ACCEPTABLE DEVIATION PART ARE NOT AIRWORTHY

FOAM, SBR/EPDM/CR BLEND BLACK, ASTM D1056 2A2, 1/2" THK BRITTLNESS TEMP. OF-40F, IAW ASTM D 746, FMVSS 302  
ADHESIVE: LA4009NOVOC

*SP 14-3-27*

### PO Instructions: Procurement Quality Clauses

- A004 faa-pma/tso
- A005 right of entry
- A007 first article inspection (fai)
- A016 personnel qualification
- A026 certification of material conformance
- A027 flammability test *146x10 Fuz PS*
- A040 notification of quality escape
- A041 quality management system

*Approved*

*14/3/10*